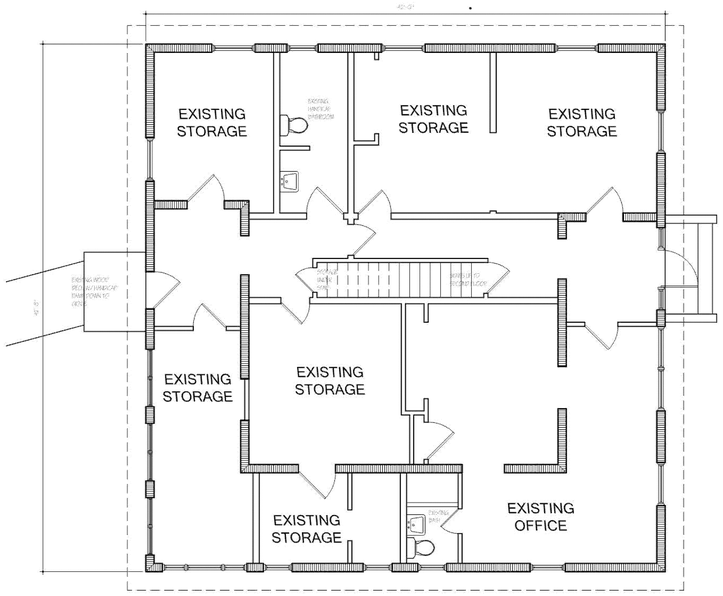

EXISTING FIRST FLOOR PLAN

SCALE: 3/16" = 1'-0"

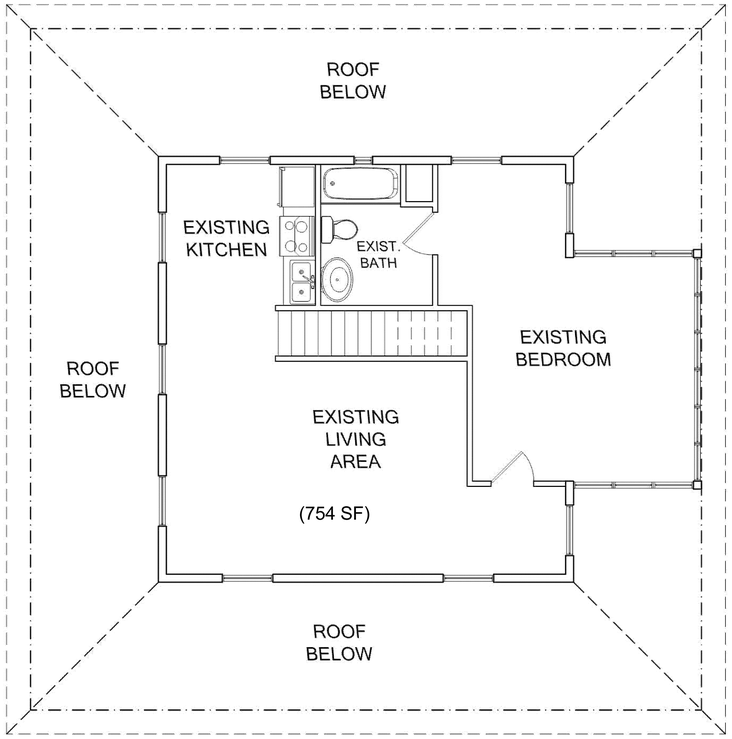

EXISTING SECOND FLOOR PLAN

SCALE: 1/4" = 1'-0"

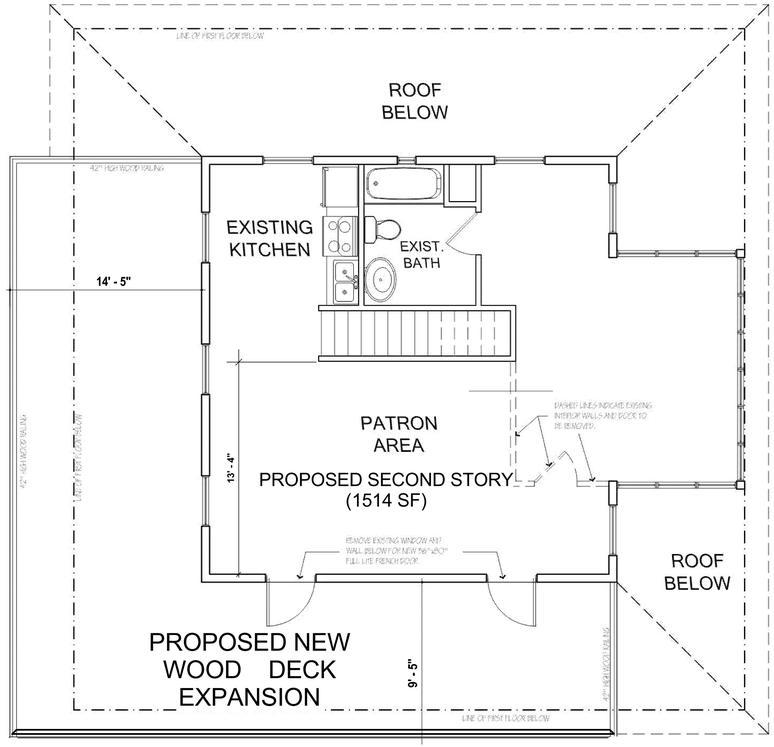

NEW SECOND FLOOR PLAN - RECEPTION/ PRIVATE MEETING ROOM

SCALE: 1/4" = 1'-0"

NOT FOR CONSTRUCTION - DO NOT SCALE

Allison Kaffka Architect
Architecture Visualization
AR-0015780
5303 4th Avenue West
Bradenton, Florida 34209
phone: 941-448-9525
al@allisonkaffka.com
Allison Trice Kaffka

4402 124th Street West
Post Office Box 387
Cortez, Florida. 34215
Phone: (941) 795-1984
Fax: (941) 798-9944
Lic. #: CB CGC014017
WHITEHEAD CONSTRUCTION INC.

AR-0015780

MARVISTA REMODEL
NORTH BUILDING
760 BROADWAY STREET
LONGBOAT KEY, FLORIDA

Revision Date:
2-26-13

IMPORTANT!!! VERIFY PLOTTED LENGTH MEASURES EXACTLY 1.5"

Date: 10/05/12
Scale: As Noted
Checked: Checker
Drawn: Author

SHEET TITLE: HOUSE AS-BUILT

PROJECT NO. MARV

SHEET NO. AH-1.0

LEFT ELEVATION

EXISTING MOORES ELEVATION SCALE: 1/4" = 1'-0"

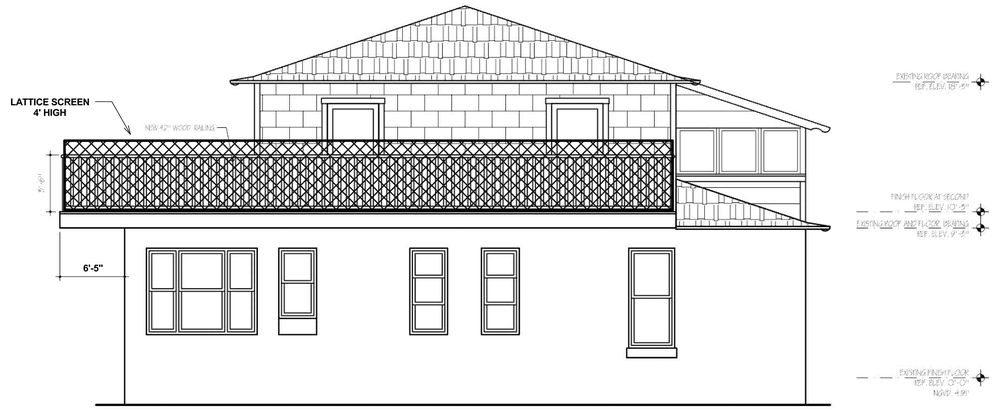

LEFT ELEVATION

PROPOSED NEW MOORES ELEVATION SCALE: 1/4" = 1'-0"

BROADWAY STREET ELEVATION

EXISTING SCALE: 1/4" = 1'-0"

BROADWAY STREET ELEVATION

PROPOSED NEW SCALE: 1/4" = 1'-0"

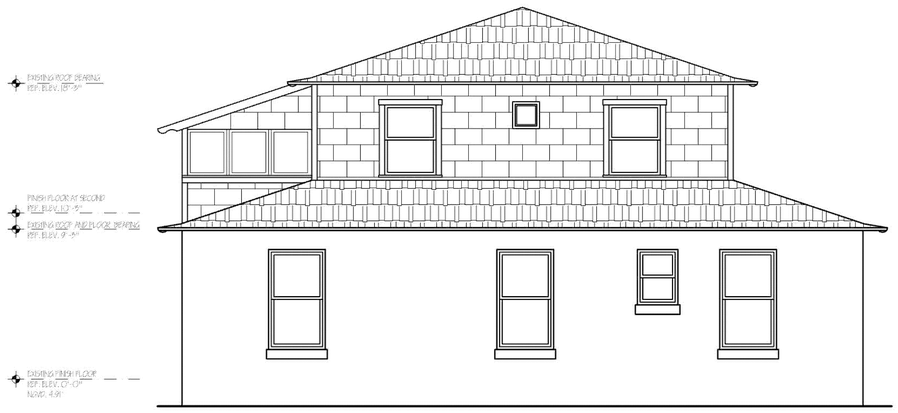

RIGHT ELEVATION

EXISTING LOIS AVENUE ELEVATION SCALE: 1/4" = 1'-0"

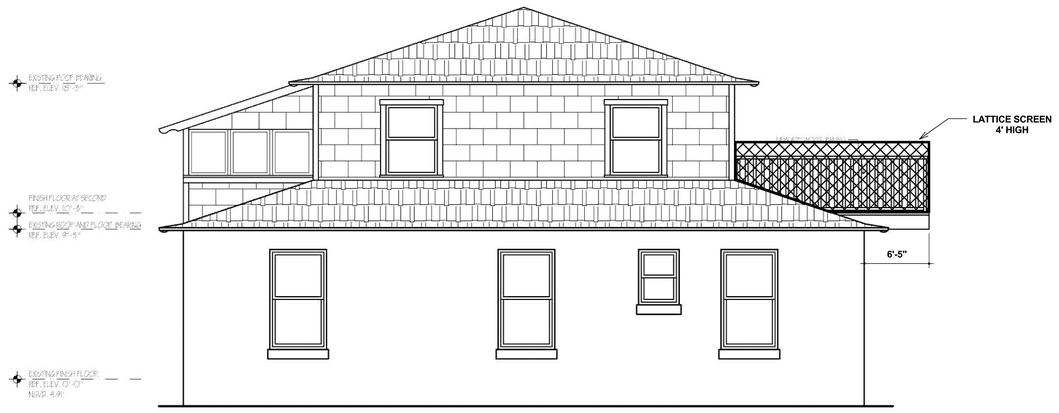

RIGHT ELEVATION

PROPOSED NEW LOIS AVENUE ELEVATION SCALE: 1/4" = 1'-0"

CONTRACTOR SHALL CHECK AND VERIFY ALL DIMENSIONS AND COORDINATE AND CO
IN THE FIELD. ALL DISCREPANCIES AND CONFLICTS SHALL BE REPORTED TO THE DE
WRITING PRIOR TO PROCEEDING OR CONTINUING WITH CONSTRUCTION. UNREPORTED
DISCREPANCIES AND CONFLICTS SHALL REMAIN THE RESPONSIBILITY OF THE CONTI

NOT FOR CONSTRUCTION - DO NOT SCALE

AR-0015780

Allison Trice Kaffka

Allison Kaffka Architect
Architecture AR-0015780 Visualization
5303 4th Avenue West
Bradenton, Florida 34209
phone: 941-448-9525
al@allisonkaffka.com

WHITEHEAD CONSTRUCTION INC.
4402 124th Street West
Post Office Box 387
Cortez, Florida. 34215
Phone: (941) 795-1984
Fax: (941) 798-9944
Lic. #: CB CO014017

MARVISTA REMODEL
NORTH BUILDING
760 BROADWAY STREET
LONGBOAT KEY, FLORIDA

Revision Date:
2-26-13

IMPORTANT!!!
VERIFY PLOTTED LENGTH
MEASURES EXACTLY 1.5"

Date: 10/05/12
Scale: As Noted
Checked: Checker
Drawn: Author

SHEET TITLE:
HOUSE
AS-BUILT

PROJECT NO.
MARV

SHEET NO.
AH-2.0

SOUTH ELEVATION

EXISTING BAYSIDE ELEVATION SCALE: 1/4" = 1'-0"

SOUTH ELEVATION

PROPOSED NEW BAYSIDE ELEVATION SCALE: 1/4" = 1'-0"

NOT FOR CONSTRUCTION - DO NOT SCALE

CONTRACTOR SHALL CHECK AND VERIFY ALL DIMENSIONS AND COORDINATE AND CO
IN THE FIELD. ALL DISCREPANCIES AND CONFLICTS SHALL BE REPORTED TO THE DE
WRITING PRIOR TO PROCEEDING OR CONTINUING WITH CONSTRUCTION. UNREPORTED
DISCREPANCIES AND CONFLICTS SHALL REMAIN THE RESPONSIBILITY OF THE CONTI

AR-0015780

Allison Trice Kaffka

Allison Kaffka Architect
Architecture AR-0015780 Visualization
5303 4th Avenue West
Bradenton, Florida 34209
phone: 941-448-9525
al@allisonkaffka.com

4402 124th Street West
Post Office Box 387
Cortez, Florida, 34215
Phone: (941) 795-1984
Fax: (941) 798-9944
Lic. #: CB C0014017
WHITEHEAD CONSTRUCTION INC.

MARVISTA REMODEL
NORTH BUILDING
760 BROADWAY STREET
LONGBOAT KEY, FLORIDA

Revision Date:
2-26-13

IMPORTANT!!!
VERIFY PLOTTED LENGTH
MEASURES EXACTLY 1.5"

Date: 10/05/12
Scale: As Noted
Checked: Checker
Drawn: Author

SHEET TITLE:
HOUSE
AS-BUILT

PROJECT NO.
MARV

SHEET NO.
AH-2.1